

**NOTES**

1. This drawing is the property of AV Integration Distribution (India) Private Limited. Reproduction/Duplication of this drawing in part or whole is not permitted.
2. All dimension are in millimeters unless otherwise indicate.
3. Do not scale off this drawing.
4. This drawings to be read in conjunction with all relevant architectural, civil/structural, and services engineer's drawing and specifications.
5. Any discrepancies to be reported immediately to the architect.
6. For Telephone/Data requirements, see drawings by others.
7. Please maintain one feet space between the AV cables and Power cables.

**REVISION & ISSUE**

REVNO	DATE	ISSUED TO
00	14.07.2023	ZEBRA

**AS BUILT DRAWINGS FOR**

ZEBRA BAGMANE SOLARIUM CITY @ BANGALORE.

**CLIENT**




**ZEBRA TECHNOLOGIES**  
BAGMANE SOLARIUMCITY, BANGALORE

**SERVICE CONSULTANT**



Space Matrix Design Consultants Pvt. Ltd.  
#27/6 Sankey Road, Bangalore - 560 052  
FAX: Phone:080 4049 4000 080 4049 4299

**PROJECT MANAGEMENT**




**JLL**  
UB CITY, 24, LEVEL 3, CONCORDE, VITTAL MALLYA RD, BENGALURU, KARNATAKA 560001

**AV SYSTEM DESIGN&CONSULTANT**



**3CDN**  
1ST FLOOR, # 1776, 15TH MAIN, 5TH BLOCK, HBR LAYOUT, KALYAN NAGAR, BANGALORE -560043

**AV SYSTEM INTEGRATED BY**




**AVI D**  
AV Integration Distribution (India) Pvt.Ltd., #300, Samrudhi, 1st Block RT Nagar Bangalore-560032, India  
Tel : 91-80-41267472  
Fax : 91-80-41267473  
email : mail@avidindia.in  
URL : www.avidindia.in

**AS BUILT DRAWING**

2ND FLOOR  
20 PAX TRAINING ROOM  
VIDEO SCHEMATICS

DRAWN BY	SHEIK	SCALE	NTS
CHECKED BY	VETRI	DATE	14.07.2023
APPROVED BY	RAJESH	SHEET	A3/01

PROJECT NUMBER :	PC-0123-0888	REV
DRAWING NUMBER :	AVI D-ZEB-2F-20PTR-VS-02	00

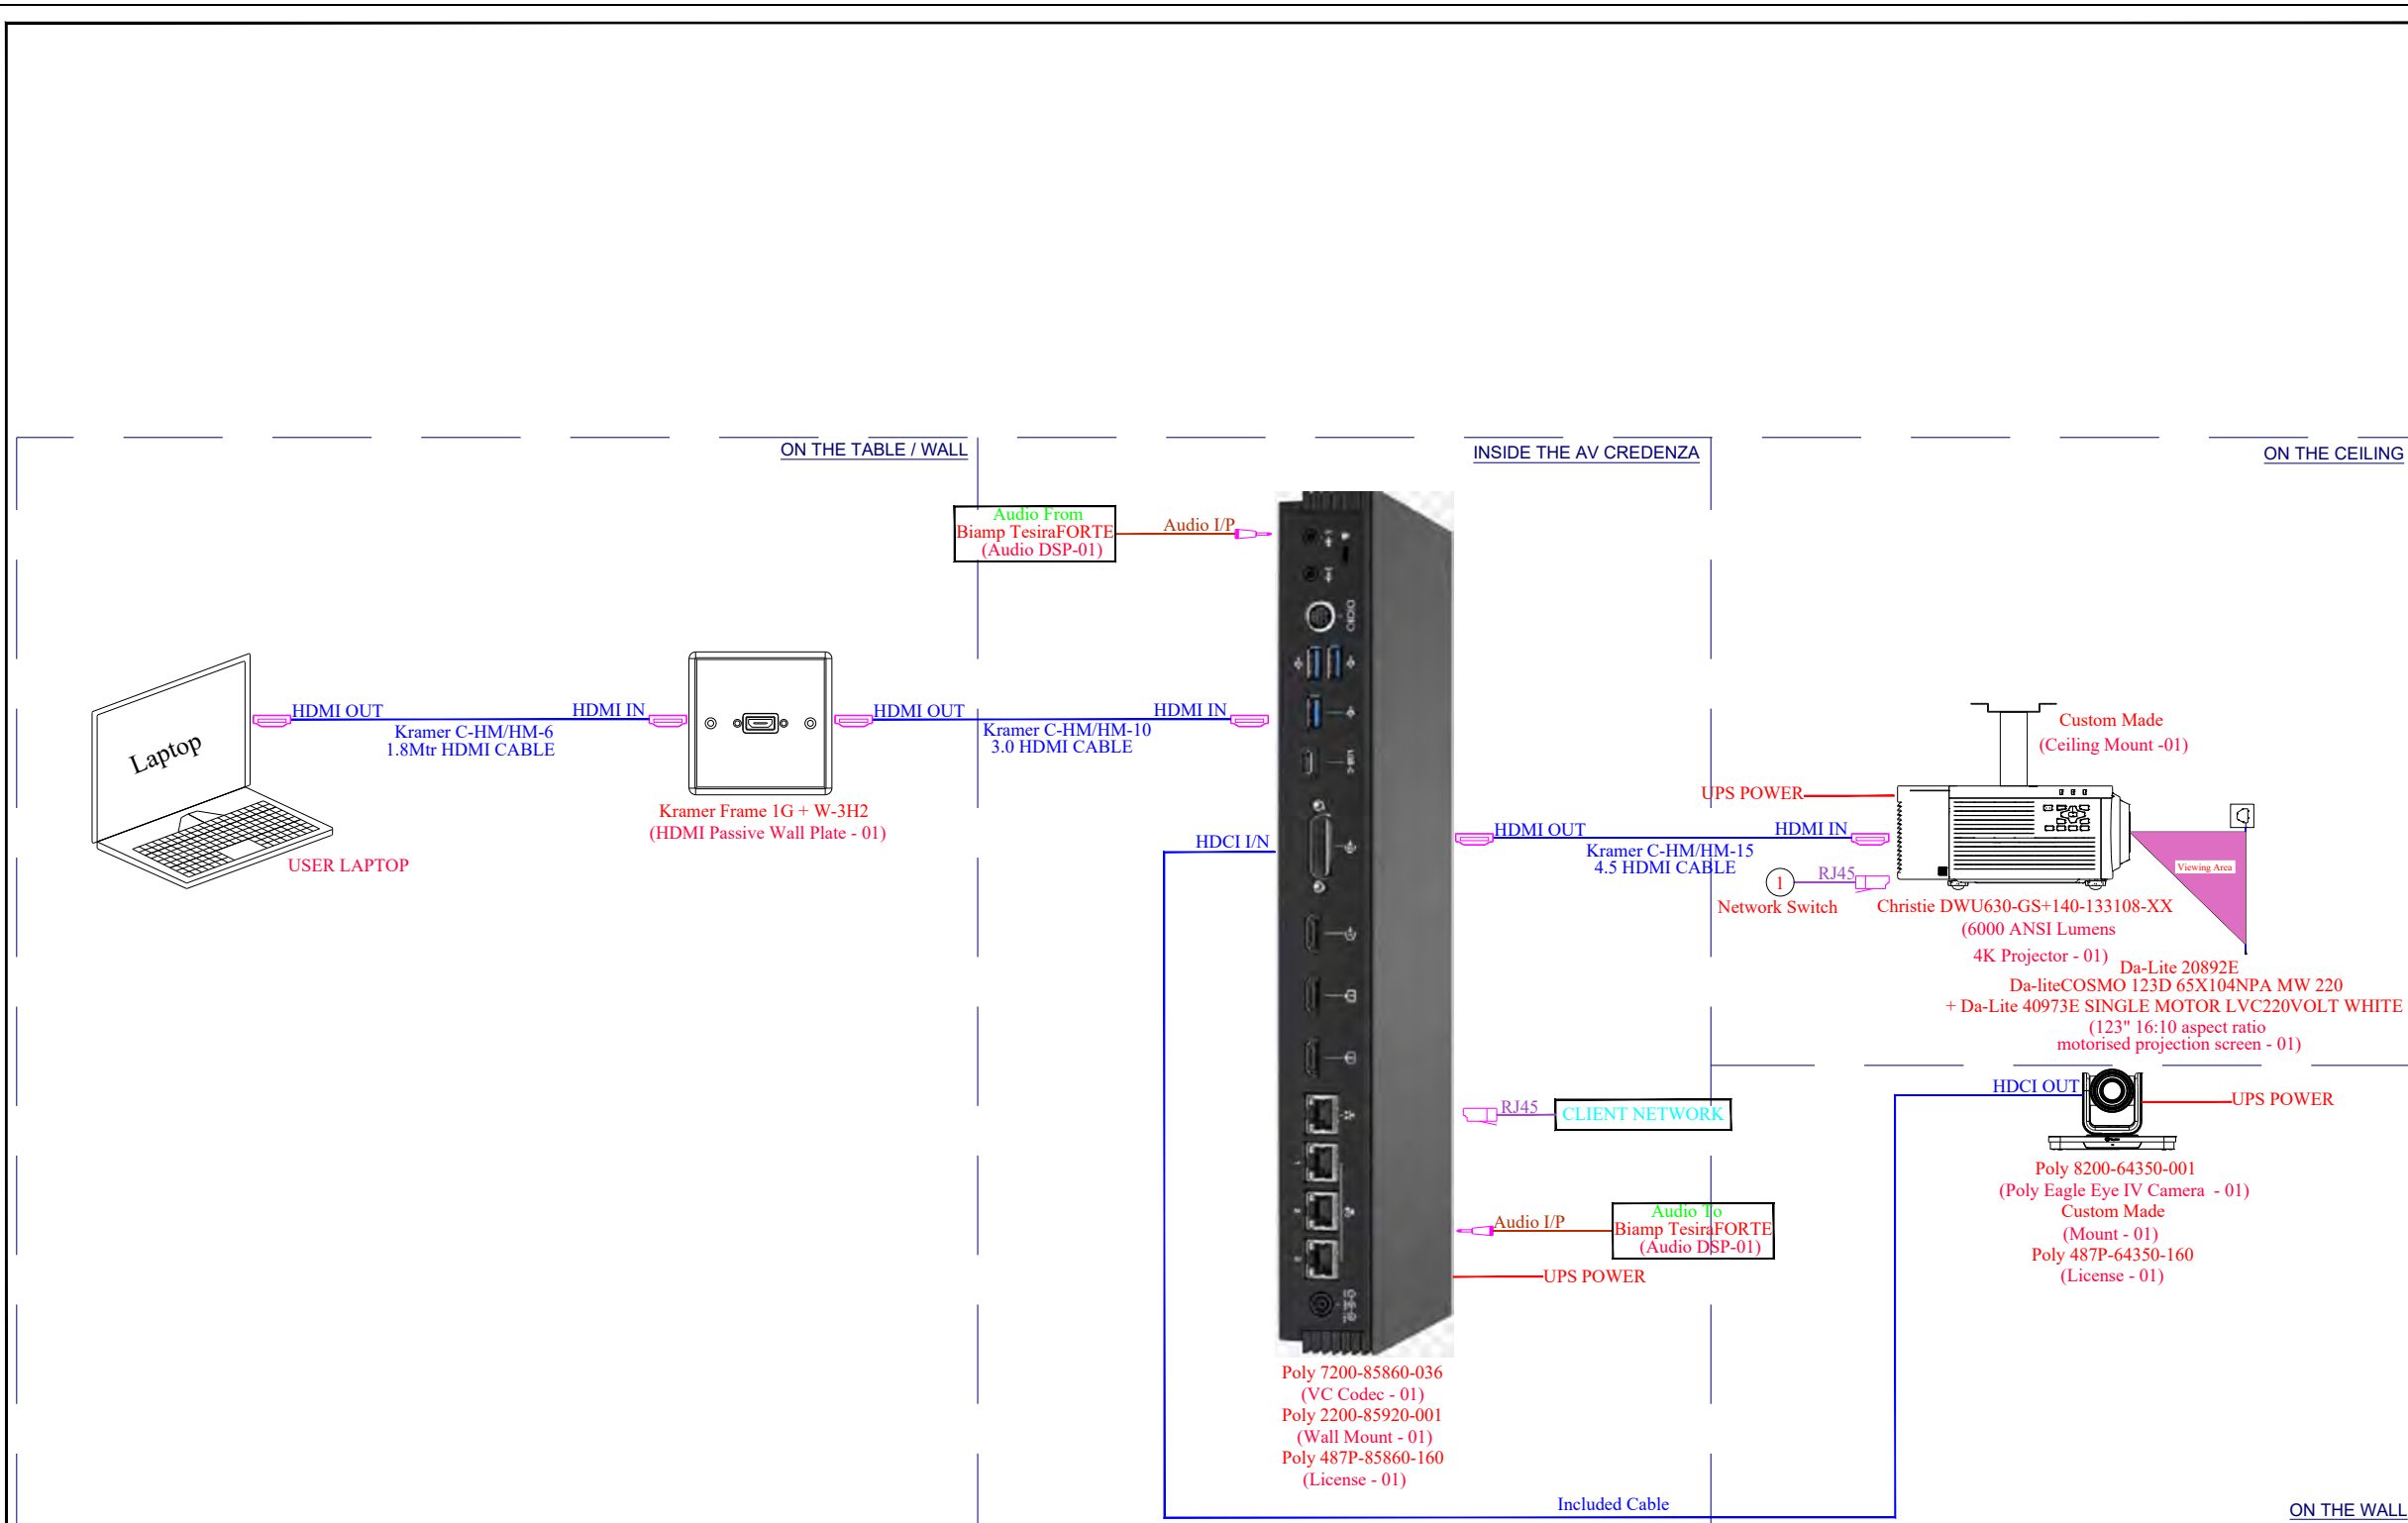

**20 PAX TRAINING ROOM VIDEO SCHEMATICS**