



Avoco AVF-8650 (86" Touch Display-01)

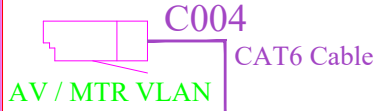

Client Network

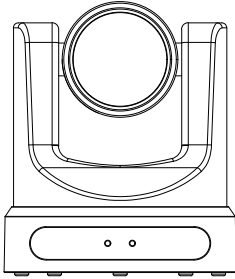

QSC IP 12x72 (PTZ Camera-01)




Client Network With POE

**ON THE WALL ABOVE THE CREDENZA**




Crestron TS-1070 (10" Touch Screen-01) (By Client)

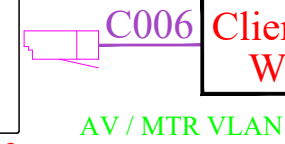

Client Network With POE


**ON THE CEILING**

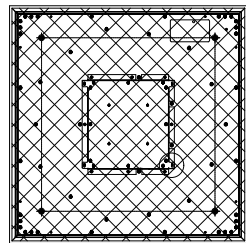

Shure MXA920 (Dante Microphone Array-01)




Client Network With POE

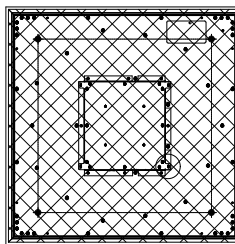


Shure MXA920 (Dante Microphone Array-01)



Client Network With POE

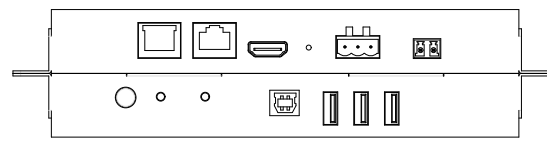


QSC Q-SYS I/O Bridge (AV to USB Bridging-01)

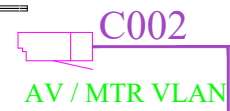


Client Network With POE

**UNDER THE TABLE**

**INSIDE THE AV RACK**

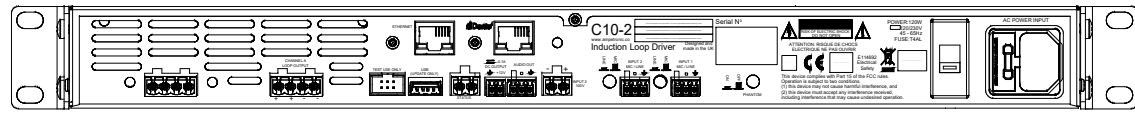


Ampetronic C10-2D (C-Series Multiloop Driver - 01)

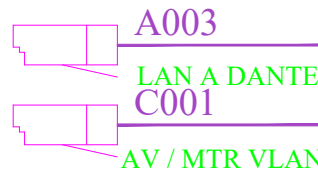


Client Network

Client Network

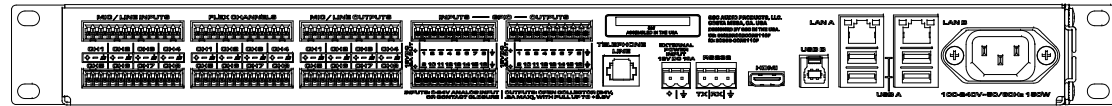

QSC-Core110f (Audio DSP-01)

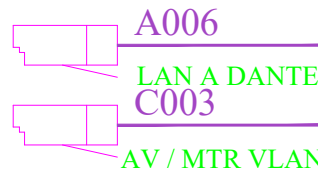

Client Network


Client Network



Crestron CP3 (Control Processor-01) (By Client)



Client Network

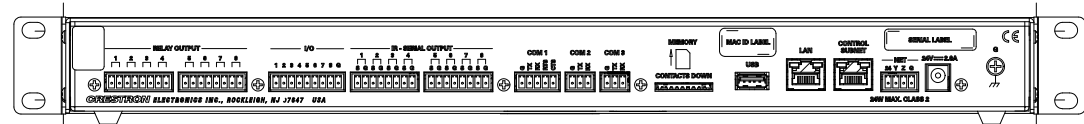

Crestron CP4N (Control Processor-01)



Client Network

**12 PAX INFORMAL BOARD ROOM (LOUNGE-CLUBHOUSE)**

**CONTROL SCHEMATICS**

**NOTES**

- 1. This drawing is the property of AV Integration Distribution (India) Pvt. Ltd., Reproduction/Duplication of this drawing in part or whole is not permitted.
- 2. All dimension are in millimeters unless otherwise indicate.
- 3. Do not scale off this drawing.
- 4. This drawings to be read in conjunction with all relevant architectural, civil/structural, and services engineer's drawing and specifications.
- 5. Any discrepancies to be reported immediately to the architect.
- 6. For Telephone/Data requirements, see drawings by others.
- 7. Please maintain one foot space between the AV cables and Power cables.

**REVISION & ISSUE**

REVNO	DATE	ISSUED TO
00	23.05.2023	SHELL

**AS BUILT DRAWINGS FOR**

PROJECT : SHELL ASGARD, CHENNAI  
SHELL ASGARD  
KFC COMMERZONE, TOWER 2,  
#2 PALLAVARAM DURAPPAKKAM RADIAL  
ROAD, PALLIKKARANAI,  
CHENNAI, TAMIL NADU 600100

**CLIENT**



SHELL  
CAMPUS 4A,  
RMZ MILLANIA BUSINESS PARK,  
NO-143, Dr. M.G.R ROAD,  
KANDANCHAWADY, PERUNGUDI,  
CHENNAI - 6000296

**ARCHITECTS**

DSP DESIGN ASSOCIATES PVT LTD.  
ARCHITECTS AND INTERIOR DESIGNERS.  
NO. 580, 1st FLOOR, OLD SYNDICATE BANK  
ROAD 1ST STAGE- INDIRANAGAR,  
BANGALORE  
Tel: 41261433/ 34/ 35  
web: www.dspdesign.com

**MEP CONSULTANT**

AECOM India Private Limited  
ASV Ramana Tower,  
3rd Floor, Old No. 37 & 38, New No.52,  
Venkataramayana Road, T.Nagar  
Chennai - 600 017, India  
T +91 44 4965 6666

**PROJECTS & DEVELOPMENT SERVICES**



JONES LANG LASALLE PROPERTY  
CONSULTANTS(INDIA) PVT LTD.,  
CHENNAI..

**AV SYSTEM INTEGRATED BY**



AV Integration Distribution (India) Pvt.Ltd.,  
#300, Samrudhi, 1st Block RT Nagar  
Bangalore-560032, India  
Tel : 91-80-41267472  
Fax : 91-80-41267473  
email : mail@avidindia.in  
URL : www.avidindia.in

**DRAWING TITLE**

6TH FLOOR  
12PAX INFORMAL BOARD ROOM (LOUNGE CLUBHOUSE)  
CONTROL SCHEMATICS

DRAWN BY	MANOJ	SCALE	NTS
CHECKED BY	VETRI	DATE	23.05.2023
APPROVED BY	RAJESH	SHEET	A3/01
PROJECT NUMBER	PC-0622-00860	REV	
DRAWING NUMBER	AVID-SH-INFBR-SCH-01	REV	00