ON THE CEILING

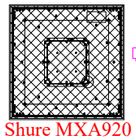

A001
CAT6 Cable
DANTE VLAN
Client Network With POE

Shure MXA920
(Dante Ceiling
Microphone Array-01)

A002
CAT6 Cable
DANTE VLAN
Client Network With POE

Shure MXA920
(Dante Ceiling
Microphone Array-02)

UNDER THE TABLE

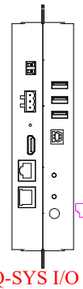

C002
AV / MTR VLAN
Client Network With POE

QSC Q-SYS I/O Bridge
(AV to USB Bridging-01)

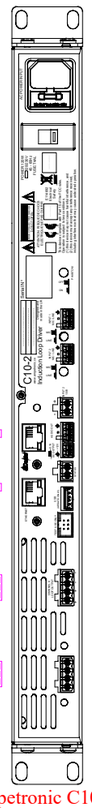

Client Network
A003
LAN A DANTE

Client Network
C001
LAN B AV / MTR VLAN

A004

A005

To Copper wire Room

Ampetronic C10-2D
(C-Series Multiloop Driver - 01)

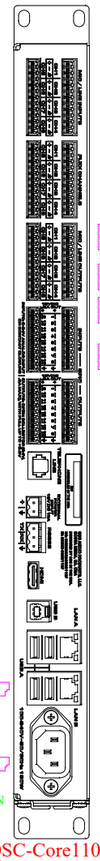

Client Network
A006
LAN A DANTE

Client Network
C003
LAN B AV / MTR VLAN

QSC-Core110f
(Audio DSP - 01)
QSC SLDAN-32-P
(Dante Licence- 01)

INSIDE THE AV RACK

A007
A008
A009
A010

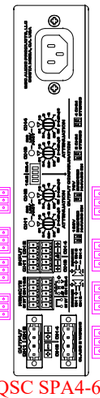

A007
A008
A009
A010

CHANNEL-1
A011
CHANNEL-2
A012
CHANNEL-3
A013
CHANNEL-4
A014

QSC SPA4-60
(Four Channel Amplifier-01)
(125Watts @ 100V)Per Channel

ON THE CEILING

A011

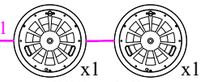

x1 x1

QSC AD-C6T
(Ceiling Speaker-01&02)
Tap(2x30W=60W) @ 100V

A012

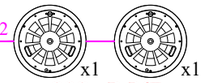

x1 x1

QSC AD-P6T
(Ceiling Speaker-01&02)
Tap(2x30W=60W) @ 100V

A013

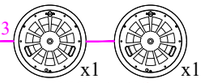

x1 x1

QSC AD-P6T
(Ceiling Speaker-03&04)
Tap(2x30W=60W) @ 100V

A014

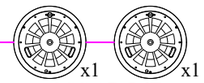

x1 x1

QSC AD-P6T
(Ceiling Speaker-05&06)
Tap(2x30W=60W) @ 100V

12 PAX INFORMAL BOARD ROOM (LOUNGE-CLUBHOUSE)
AUDIO SCHEMATICS

NOTES

1. *This drawing is the property of AV Integration Distribution (India) Pvt. Ltd., Reproduction/Duplication of this drawing in part or whole is not permitted.*
2. *All dimension are in millimeters unless otherwise indicate.*
3. *Do not scale off this drawing.*
4. *This drawings to be read in conjunction with all relevant architectural,civil/structural, and services engineer's drawing and specifications.*
5. *Any discrepancies to be reported immediately to the architect.*
6. *For Telephone/Data requirements,see drawings by others.*
7. *Please maintain one feet space between the AV cables and Power cables.*

REVISION & ISSUE

REVNO	DATE	ISSUED TO
00	23.05.2023	SHELL

AS BUILT DRAWINGS FOR

PROJECT : SHELL ASGARD, CHENNAI
SHELL ASGARD
KRC COMMERZONE, TOWER 2,
#2 PALLAVARAM DURAPPAKKAM RADIAL ROAD, PALLIKKARANAI,
CHENNAI, TAMIL NADU 600100

CLIENT

SHELL
CAMPUS 4A,
RMZ MILLANIA BUSINESS PARK,
NO-143, Dr. M.G.R ROAD,
KANDANCHAWADY, PERUNGUDI,
CHENNAI - 6000296

ARCHITECTS

DSP DESIGN ASSOCIATES PVT LTD.
ARCHITECTS AND INTERIOR DESIGNERS.
NO. 580, 1st FLOOR, OLD SYNDICATE BANK ROAD 1ST STAGE- INDIRANAGAR,
BANGALORE
Tel: 41261433/ 34/ 35
web: www.dspdesign.com

MEP CONSULTANT

AECOM India Private Limited
ASV Ramana Tower,
3rd Floor, Old No. 37 & 38, New No.52,
Venkatnarayana Road, T.Nagar
Chennai - 600 017, India
T +91 44 4965 6666

PROJECTS & DEVELOPMENT SERVICES

JONES LANG LASALLE PROPERTY CONSULTANTS(INDIA) PVT LTD.,
CHENNAI..

AV SYSTEM INTEGRATED BY

AV Integration Distribution (India) Pvt.Ltd.,
#300, Samrudhi, 1st Block RT Nagar
Bangalore-560032, India
Tel : 91-80-41267472
Fax : 91-80-41267473
email : mail@avidindia.in
URL : www.avidindia.in

DRAWING TITLE

6TH FLOOR
12PAX INFORMAL BOARD ROOM (LOUNGE CLUBHOUSE)
AUDIO SCHEMATICS

DRAWN BY	MANOJ	SCALE	NTS
CHECKED BY	VETRI	DATE	23.05.2023
APPROVED BY	RAJESH	SHEET	A3/01

PROJECT NUMBER : PC-0622-00860
DRAWING NUMBER : AVID-SH-INFBR-SCH-01
REV 00